


SHADOW HILL SHOPING CENTER

2079 N. JONES

AREA TABULATION

LEASABLE SPACE = 750 S.F.

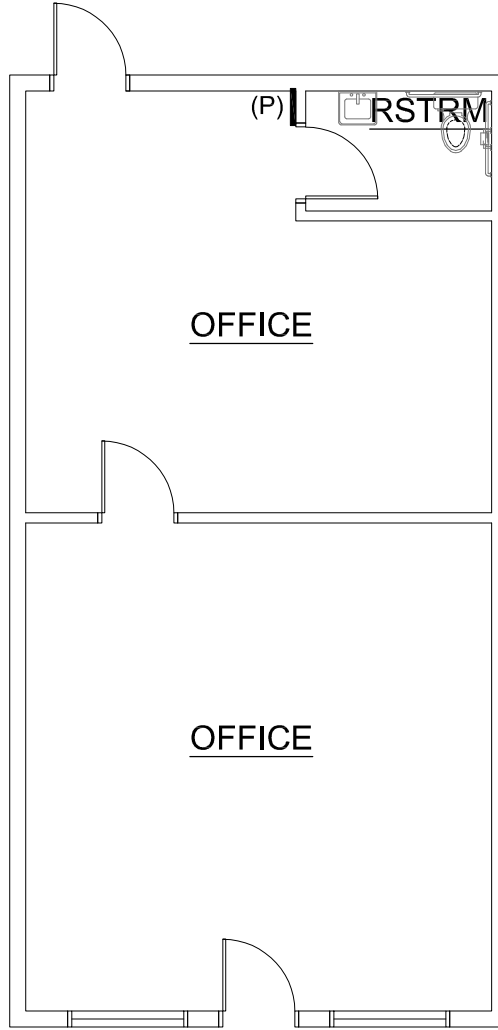

NOTES:

- (D) DATA
- (E) ELECTRIC PANEL
- (C) CABLE

FIRE SPRINKLED - NO
 FIRE ALARMED - NO

1
#2079 AS-BUILT PLAN

A1.00

#	DATE	DESCRIPTION			
REVISIONS			DRAFTER INFORMATION	PROJECT INFORMATION	DRAWING INFORMATION
			DRAFTING COMPANY: STREAMLINE CONCEPT DRAFTING & DESIGN, LLC	PROJECT NAME: SHADOW HILLS SHOPPING CENTER	PLOT DATE: 02-19-2019
			COMPANY ADDRESS: 6935 ALIANTE PARKWAY, STE. 104-432 NORTH LAS VEGAS, NEVADA 89084	PROJECT ADDRESS: 2041 NORTH JONES BLVD. LAS VEGAS, NEVADA 89108	PHASE AS-BUILT SUBMITTAL
			COMPANY CONTACT: DYLAN YORKE - OWNER 702-416-0795	PROJECT NUMBER: 016-18005	SHEET NAME AS-BUILT FLOOR PLAN
					SHEET NO. A1.00