


HIDDEN CANYON

UNIT - 210

AREA TABULATION

SUITE 210 LEASABLE SPACE =

800 S.F.

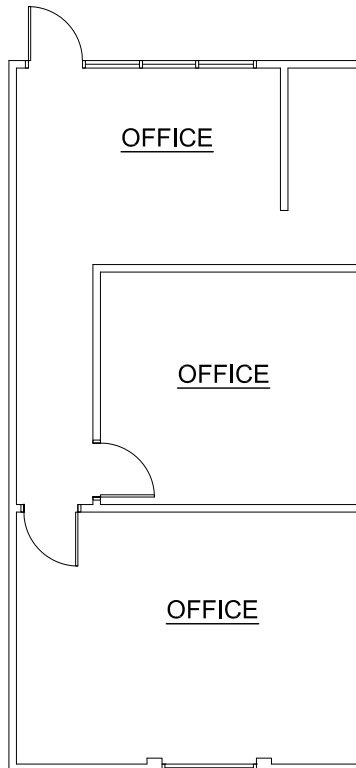

1 #210 AS-BUILT PLAN
A1.00

NOTES:

- (D) DATA
- (E) ELECTRIC PANEL
- (C) CABLE

FIRE SPRINKLED - YES
 FIRE ALARMED - YES

| # | DATE | DESCRIPTION | | | |
|-----------|------|-------------|---|---|-----------------------------------|
| REVISIONS | | | DRAFTING COMPANY: STREAMLINE CONCEPT DRAFTING & DESIGN, LLC | PROJECT NAME: HIDDEN CANYON PLAZA SHOPPING CENTER | PLOT DATE: 02-29-2020 |
| | | | COMPANY ADDRESS: 6935 ALIANTE PARKWAY, STE. 104-432 NORTH LAS VEGAS, NEVADA 89084 | PROJECT ADDRESS: 3915-3965 MARTIN LUTHER KING BOULEVARD NORTH LAS VEGAS, NEVADA 89032 | PHASE AS-BUILT SUBMITTAL |
| | | | COMPANY CONTACT: DYLAN YORKE - OWNER 702-416-0795 | PROJECT NUMBER: 016-18001 | SHEET NAME AS-BUILT FLOOR PLAN |
| | | | | | SHEET NO. A1.00 |