


HIDDEN CANYON

UNIT - 217

AREA TABULATION

SUITE 217 LEASABLE SPACE =

630 S.F.

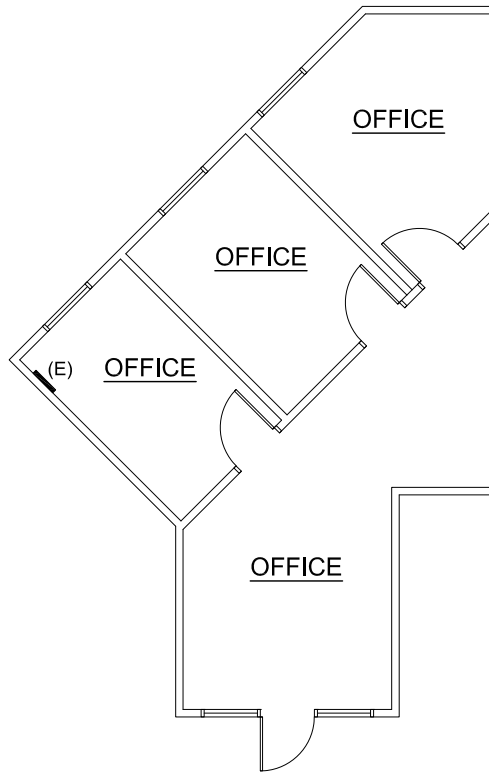

1 #217 AS-BUILT PLAN
A1.00

NOTES:

- (D) DATA
- (E) ELECTRIC PANEL
- (C) CABLE

FIRE SPRINKLED - YES
 FIRE ALARMED - YES

#	DATE	DESCRIPTION			
REVISIONS			DRAFTER INFORMATION DRAFTING COMPANY: STREAMLINE CONCEPT DRAFTING & DESIGN, LLC COMPANY ADDRESS: 6935 ALIANTE PARKWAY, STE. 104-432 NORTH LAS VEGAS, NEVADA 89084 COMPANY CONTACT: DYLAN YORKE - OWNER 702-416-0795	PROJECT INFORMATION PROJECT NAME: HIDDEN CANYON PLAZA SHOPPING CENTER PROJECT ADDRESS: 3915-3965 MARTIN LUTHER KING BOULEVARD NORTH LAS VEGAS, NEVADA 89032 PROJECT NUMBER: 016-18001	DRAWING INFORMATION PLOT DATE: 02-29-2020 PHASE: AS-BUILT SUBMITTAL SHEET NAME: AS-BUILT FLOOR PLAN SHEET NO. A1.00